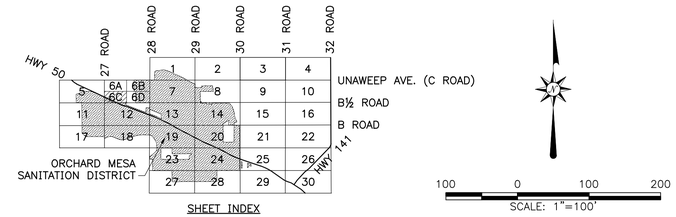

SCALE: 1"=100'

SEE SHEET 6A

SEC 25
NW1/4

OAK CT

B 3/4 RD

27 5/8 RD

27½ ROAD

DRAINAGE DITCH

AV

SHERMAN DR

ARTESIA HEIGHTS

DOROTHY

MIRIAM AV

FISCHER AV

WEST PARKVIEW

EAST PARKVIEW

PARKVIEW

SEE SHEET 5D

SEE SHEET 6D

OMSD BOUNDARY

MH CHL1
R 4645.24
W 32.64
S 32.54
N 32.44

MH CHL2
R 4644.69
W 33.37
E 33.32

MH-EXCTY-2
R 4645.24
S 34.32

MH-SA9
R 4647.03
N 36.69
S 36.73

MH-SA8
R 4653.02
N 39.69
W 41.11
S 43.70
Drop S 40.09

MH-SM52
R 4646.10
N CITY
S 33.58

44'-8"
87'-8"
209'-4"
355'-8"
265'-8"
145'-15"

B 1/2 RD

OMSD BOUNDARY

SEE SHEET 12A

ORCHARD MESA SANITATION DISTRICT
SEWAGE COLLECTION SYSTEM
GRAND JUNCTION, COLORADO

Design by: ADR
Drafted by: MJH
Date: 09-01
Project No. 9844
Sheet 06c

WestWater Engineering
2516 Foresight Circle, #1
Grand Junction, CO 81505
(970) 241-7076

SOURCE: Parcels from Mesa County Geographic Information System (GIS). Manhole locations from City of Grand Junction, Global Positioning System (GPS) survey in field by LANDesign, 1999-2001 and from as-built drawings. Actual locations may vary.

DATUM: North American Vertical Datum 1988 (NAVD 88) used for elevation information.

NOTE: This information is for the use of Orchard Mesa Sanitation District for approximate location, size and depth of sanitary sewer lines. This information should not be relied on for design or construction of sanitary sewer lines.

SCALE: HORIZONTAL 1" = 100'
VERTICAL NONE

SECTION 25
N 1/2

REVISIONS	DATE
PERIODIC REVIEW	12-12

SHEET 6C